



**SURVEYOR'S CERTIFICATE:**

I HEREBY CERTIFY THAT I AM A PROFESSIONAL LAND SURVEYOR, REGISTERED IN THE STATE OF ALASKA AND THAT A SURVEY WAS MADE BY ME OR UNDER MY DIRECT SUPERVISION OF THE PARCEL SHOWN HEREON AND THAT THE SURFACE IMPROVEMENTS SITUATED AS-BUILT ARE WITHIN THE PROPERTY LINES AND DO NOT ENCR OACH ON THE ADJACENT PROPERTY, UNLESS SHOWN OTHERWISE. ALSO ALL LOTS, ROADS, AND EASEMENTS ARE TO THE BEST OF MY KNOWLEDGE SHOWN HEREON.

03-117

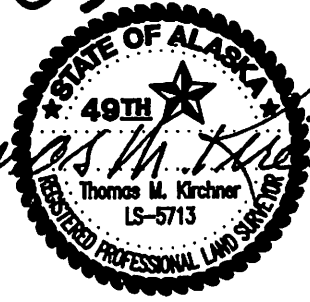

28 March 03  
DATE

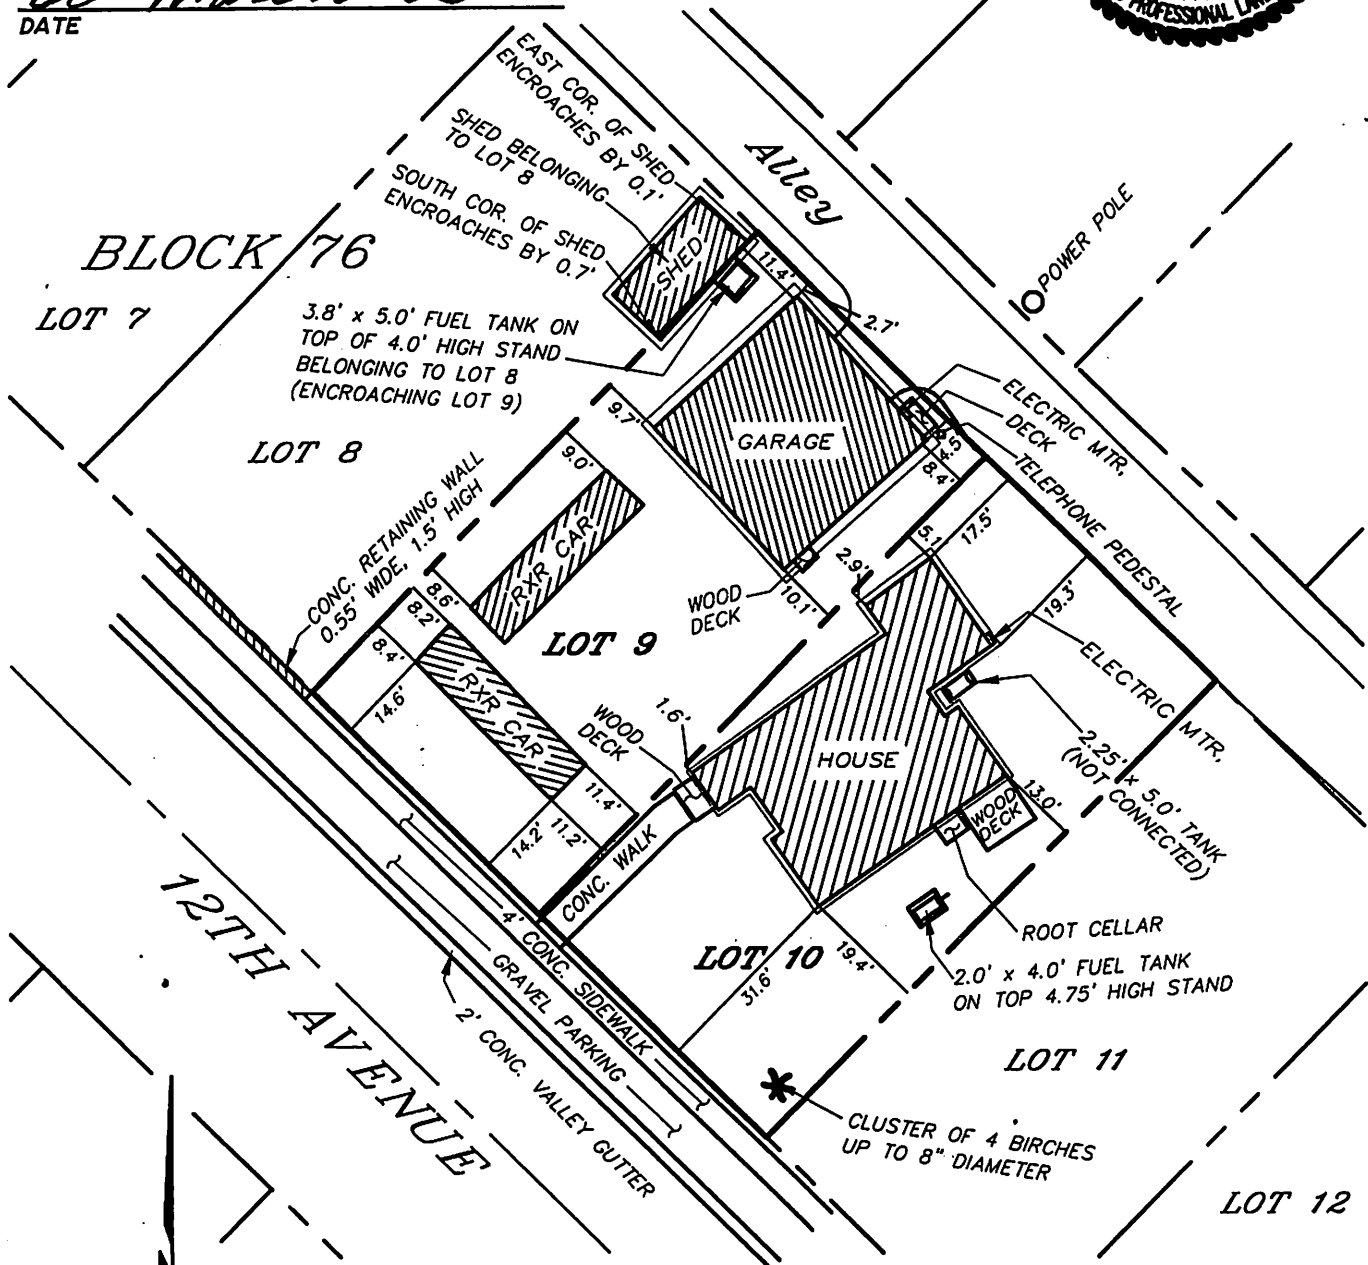

SCALE: 1"=30'

AS-BUILT DRAWING  
**LOTS 9 & 10, BLOCK 76**  
**SKAGWAY TOWNSITE**  
 SKAGWAY, ALASKA

DATE: 19 MAR 2003 FILE NO.: 03003.01-532